

STATE OF UTAH
DEPARTMENT OF NATURAL RESOURCES
DIVISION OF OIL, GAS AND MINING
 1594 West North Temple - Suite 1210
 Box 145801
 Salt Lake City, Utah 84114-5801
 Telephone: (801) 538-5291
 Fax: (801) 359-3940

LARGE MINING OPERATIONS PROGRESS REPORT
January 1, 20 12 to December 31, 20 12

The information required in this form is based on provisions of the Mined Land Reclamation Act, Title 40-8, and the R647 rules under the Utah Minerals Regulatory Program. It is due January 31 of each year.

1. Mine Permit Number: M470066
2. Mine Name: Diamond Mountain Resources
3. Name of Operator/Permittee: Deseret Generation & Transmission/Diamond Mountain Resources

Note: If Operator's address, company representative or phone number have changed, please provide a replacement page for the Notice of Intention together with form MR-REV available on the Division's web page at https://fs.ogm.utah.gov/pub/mines/minerals_related/forms/MR-REV.pdf

*See cover letter.

4. Report the gross amount of ore mined and waste moved:

Gross Ore Mined 0 Tons, or 0 yd³
 Waste Material Moved 0 Tons, or 0 yd³

**This actually happened in 2011, but was accidentally omitted on 2011's report.

5. New disturbance created during the year 0.6 ** Acres
 Area reclaimed during the year 0.0 Acres
 Total disturbed area at the end of the year 15.1 Acres*

*The total disturbed area should not be greater than the permitted/bonded acreage


6. Briefly describe the reclamation work performed during the past year. (Submit form MR-SITE (https://fs.ogm.utah.gov/pub/mines/minerals_related/forms/MR-SITE.pdf) to apply for full or partial bond/site release). Attach additional sheets if needed.
None was competed.

7. Include an updated map depicting surface disturbance and reclamation performed during the year (Rule R647-4-105). See attached.

I hereby certify the information provided in this report is true and correct to the best of my knowledge and belief.

Name (Typed or Print): Eric C. Olsen, P.E.


Title of Operator: Environmental Superintendent

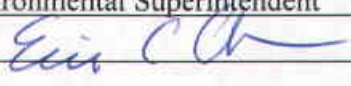Signature of Operator: 

Date: 1-15-2013

pb

O:\FORMS\reports\MR-AR-LMO2011.doc

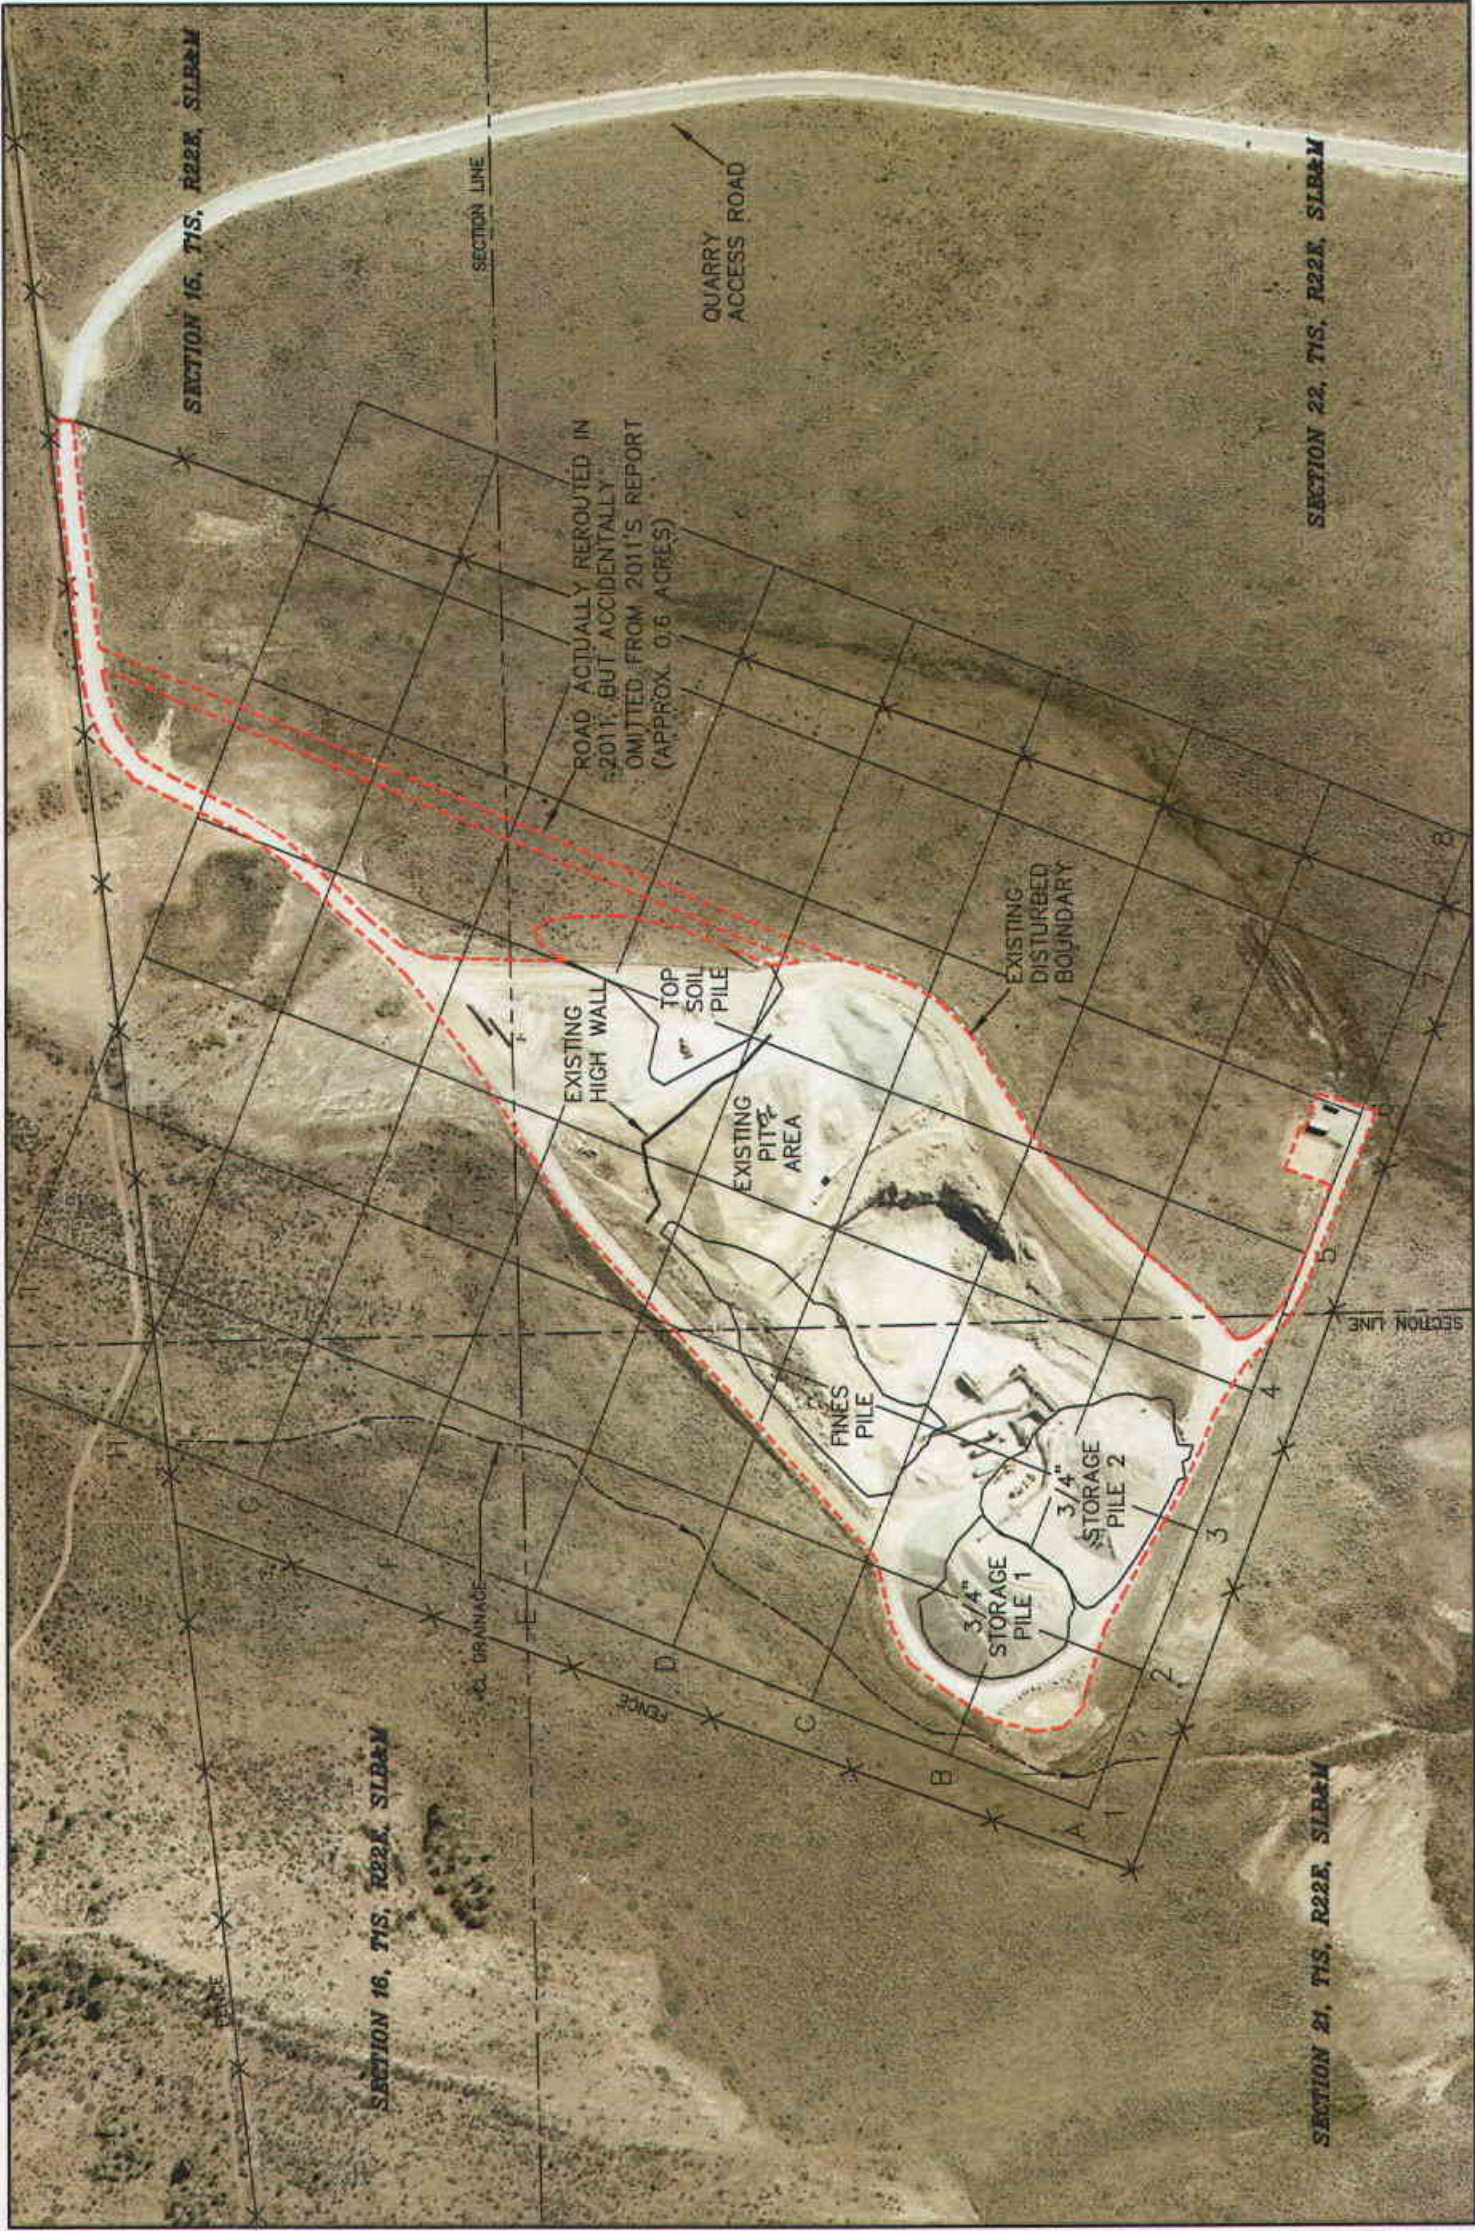

NOTE:

1. BACKGROUND PHOTO IS OLDER THAN WHAT ACTUALLY EXISTS.
2. THERE WAS NO NEW SURFACE DISTURBANCE OR RECLAMATION FOR REPORTING YEAR 2012.
3. THERE IS NO ANTICIPATED SURFACE DISTURBANCE OR RECLAMATION FOR REPORTING YEAR 2013. IT IS ANTICIPATED THAT 2014 WILL BE THE NEXT CRUSHING YEAR.
4. THERE WAS A SECTION OF THE ROAD THAT WAS REROUTED IN 2011 AND ACCIDENTALLY OMITTED FROM 2011'S REPORT (APPROX. 0.6 ACRES).



DESERET POWER ELECTRIC COOPERATIVE

LIMESTONE QUARRY MAP
2012 PROGRESS REPORT

CAD FILE : Quarry Map (1-15-13).dwg

No.	REVISIONS		DATE	BY	ENGINEERING	BY	DATE	DRAFT	BY	DATE	W.O.
						ENG	1/13		ECO	1/13	DWG.
						APVD			CHK		
									APVD		
											01152012-1

PLOT SCALE: 1"=250'



DESERET POWER
ELECTRIC COOPERATIVE

12500 East 25500 South
Vernal, Utah 84078
(435) 789-9000 Fax: (435) 781-5816

January 15, 2013

RECEIVED
JAN 24 2013
DIV. OF OIL, GAS & MINING

State of Utah
Department of Natural Resources
Division of Oil, Gas and Mining
1594 West North Temple – Suite 1210
PO Box 145801
Salt Lake City, UT 84114-5801

Re: Deseret Generation & Transmission/Diamond Mountain Resources, 2012 Progress Report & Annual Permit Fee (Permit Number: M470066)

To Whom It May Concern:

Enclosed are the 2012 Progress Report (including a mine map) and a \$500 check for the Annual Permit Fee for Diamond Mountain Resources (Permit Number: M470066). This mine is operated by Deseret Generation & Transmission.

Please note that Larry Jorgensen no longer works for Deseret Generation & Transmission. I am the new contact person for this permit. My contact information is:

Name: Eric C. Olsen, P.E.
Position: Environmental Superintendent
Address: 12500 East 25500 South
Vernal, UT 84078-8525
Phone Number: (435) 781-5706
Email: eolsen@deseretpower.com

Please let me know if you have any questions, need anything else, or if I need to file a form to update the contact person for this permit if this letter is not adequate.

Sincerely,

Eric Olsen, P.E.
Environmental Superintendent

Enclosures (3)